
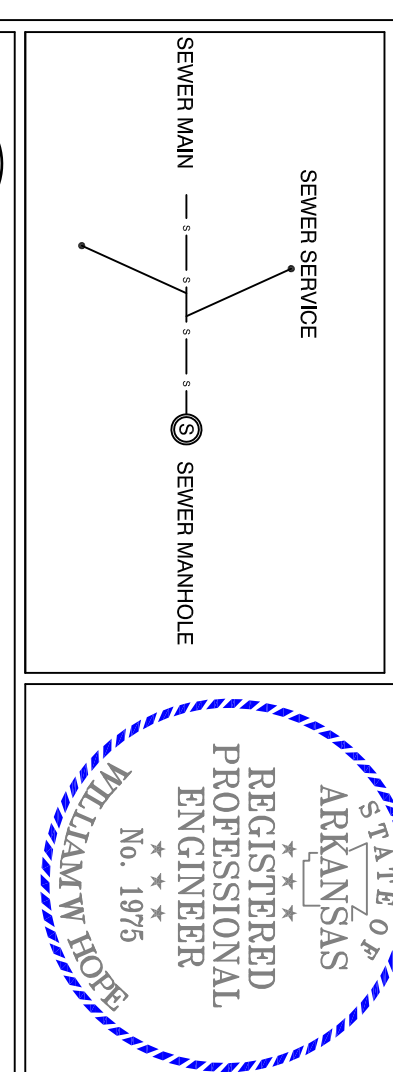


LOT NO.	REF. COR.	A (FT.)	B (FT.)
14	SW	22.88'	2.31'
15	SW	10.05'	2.98'
16	SE	0.82'	1.73'
17	SW	4.48'	3.91'
18	SW	0.49'	10.44'
19	SW	12.56'	0.84'
20	SW	11.92'	4.11'
21	NW	20.24'	12.89'
22	SE	-0.00'	9.38'
23			
24			
25			
26			
27			
28			
29			
30			

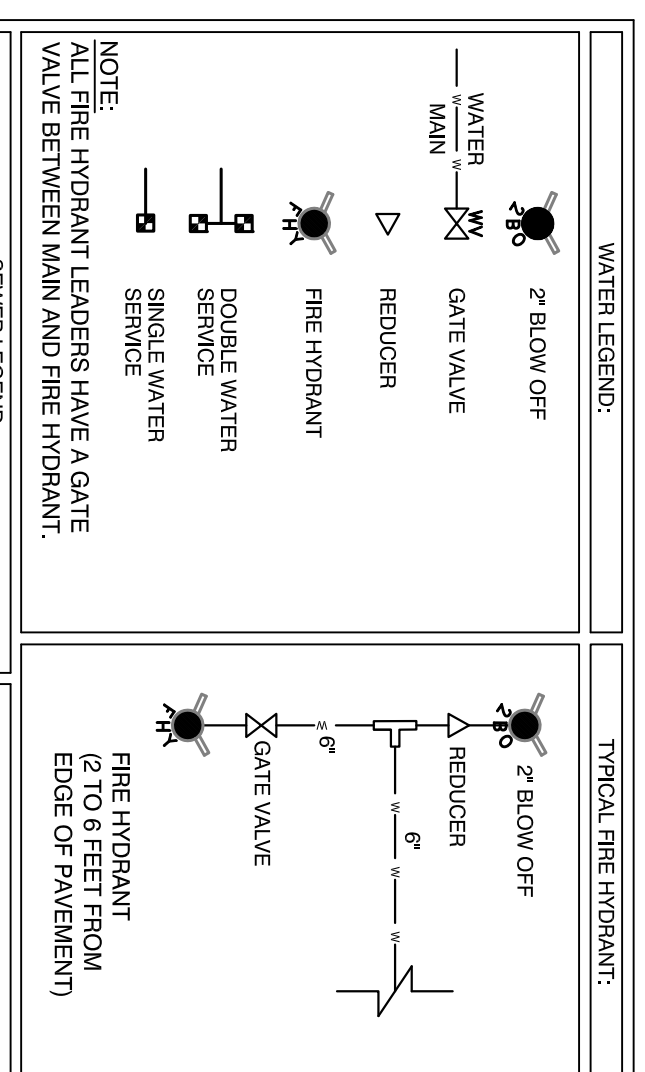

FOR USE AND BENEFIT OF:
STEPHENS-BAKER CONSTRUCTION

SANITARY SEWER & WATER AS-BUILTS
ST. JOSEPH GLENN SUBDIVISION PHASE 5
 A SUBDIVISION IN THE CITY OF ALEXANDER, SALINE COUNTY, ARKANSAS

322 North Market Street
 Benton, Arkansas
 (501) 315-0786
 Fax: (501) 315-0700
 www.hopeengineers.com

DATE: AUGUST 24, 2007
 REVISIONS:
 SHEET: 1 OF 2

CAD. BY: K. TOMPKINS
 CHECKED BY:
 SCALE: 1"=40'

DRAWING NUMBER:
07-0485